




# Appendix A (1)

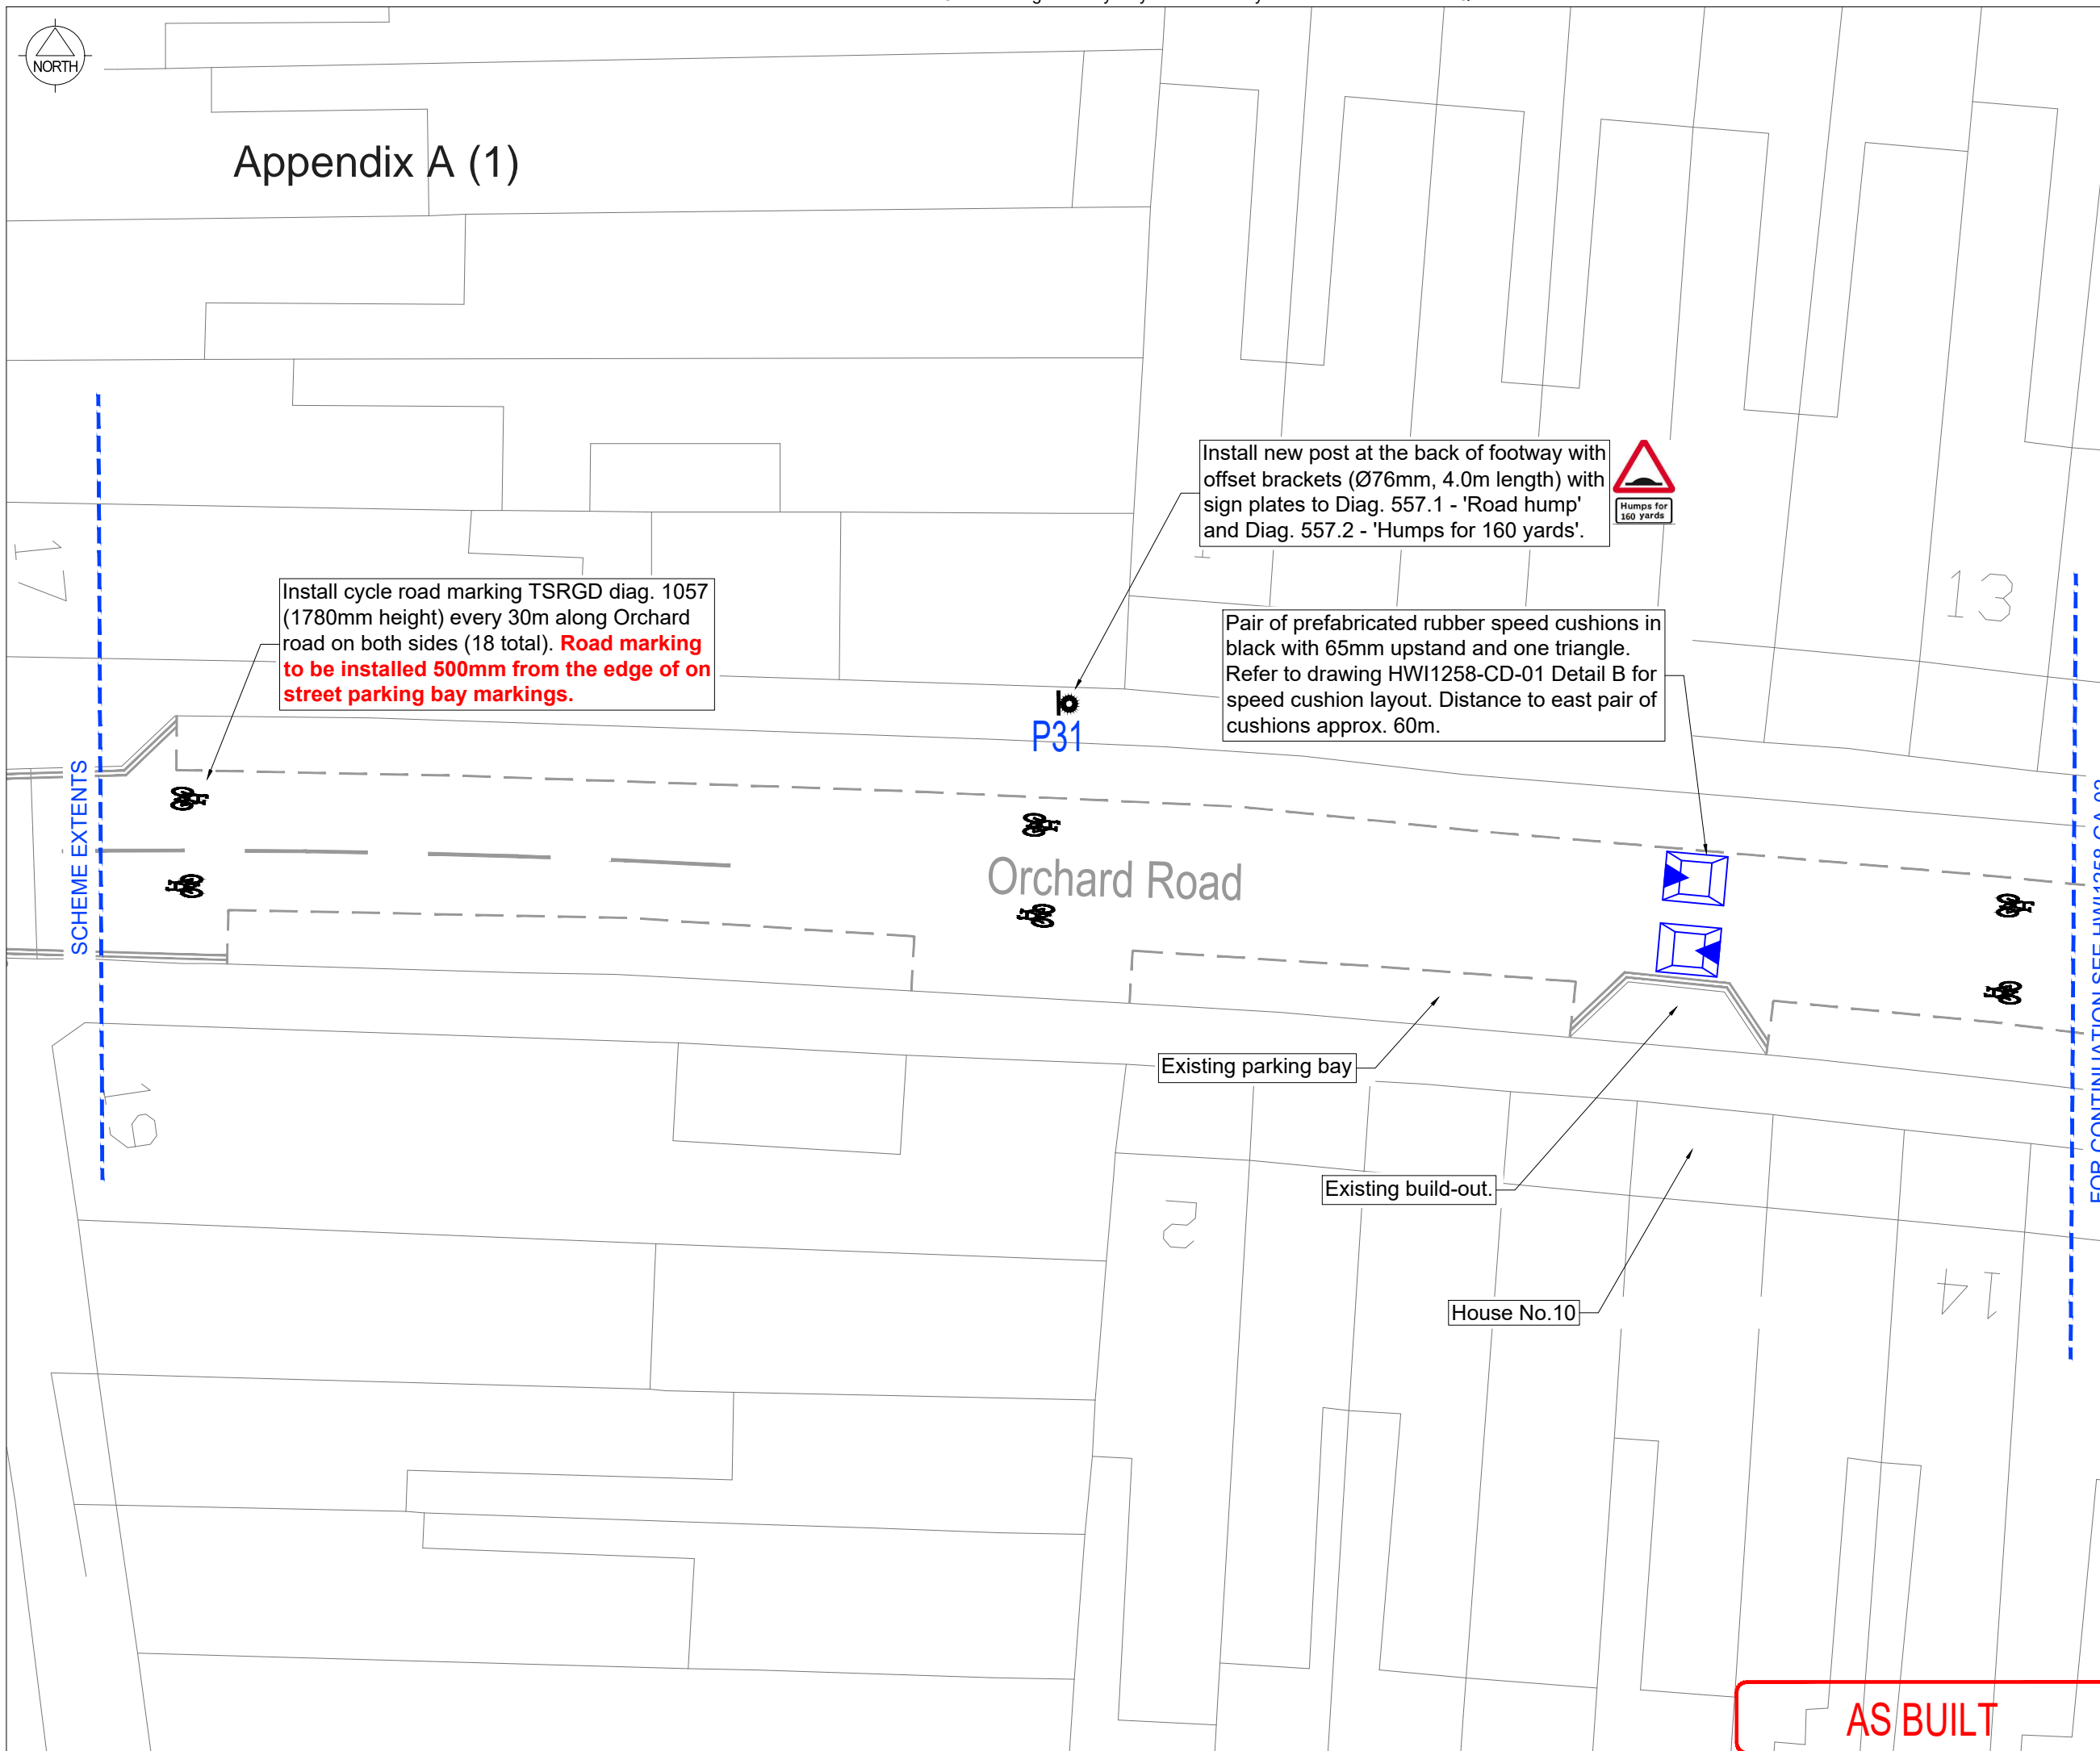

**General Notes:**

1. All dimensions in meters, unless stated otherwise on drawing. Dimensions to be checked prior to commencement of any work by Engineer on Site. Notify the Engineer of any discrepancies before ordering materials or starting excavation.
2. Traffic management to be in accordance with chapter 8 of the traffic signs manual and related codes of practice.
3. Refer to statutory undertakers records for underground services located within the site extent.
4. Drawing to be printed in colour only. Do not scale from this drawing.
5. New construction levels & road markings to tie into existing.
6. All works are to be carried out in accordance with PCC standard details unless noted otherwise.
7. All traffic signs and road markings to be in accordance with the Traffic Signs Regulations and General Directions, 2016.
8. Ordnance Survey Copy Right - Based or reproduced from the 2008 Ordnance Survey 1/1000 base with the permission of HMSO crown copyright reserved. License No. LA-100019671.
9. All electric connection to DNO to be confirmed prior to the start of the works.
10. The set of drawings is composed by the following:
  - HWI1258-LP-01 - Location Plan;
  - HWI1258-TS-01 - Traffic Sign Schedule
  - HWI1258-CD-01 - Construction Details
  - HWI1258-GA-01 to 17 - General Arrangement - Sheets 01 to 17

**Legend:**

-  Proposed rubber speed cushion 1650mm x 2000mm x 65mm. 750mm spacing between cushion pairs.
-  Proposed sign post and plate with reference number corresponding with schedule shown on drawing HWI1258-TS-01
-  Existing sign and post to be removed
-  Proposed Road Marking
-  Existing Road Marking to be removed

Rev	Date	Revision Details	Amended	Approved
F	13.09.24	As Built drawing.	EA	FL
E	08.02.24	Signs and mounting type amended.	EA	FL
D	30.01.24	Issued for construction	CM	EA
C	23.08.23	Amended following RSA2 and issued for tender	CM	EA
B	27.07.23	ISSUE FOR RSA 2	CM	EA
A	06.07.23	First issue.	CM	EA

Project  
**Active Pompey Neighbourhoods (APN)**

Drawing Title  
**General Arrangement (Preliminary Design) Sheet 1 of 17**



**Directorate of Economy, Planning and Transport**  
 Assistant Director (Infrastructure)  
 Martin Lavers BSc CEng MICE

Date: July 2023 Scale: 1:200 @ A2  
 Design/Survey by: CM Drawn by: CM Checked by: EA

Drawing No	Revision No.
<b>HWI1258-GA-01</b>	<b>F</b>

FEASIBILITY	DRAFT	CONSTRUCTION
INFORMATION	TENDER	AS BUILT *

AS BUILT