




Appendix A (3)

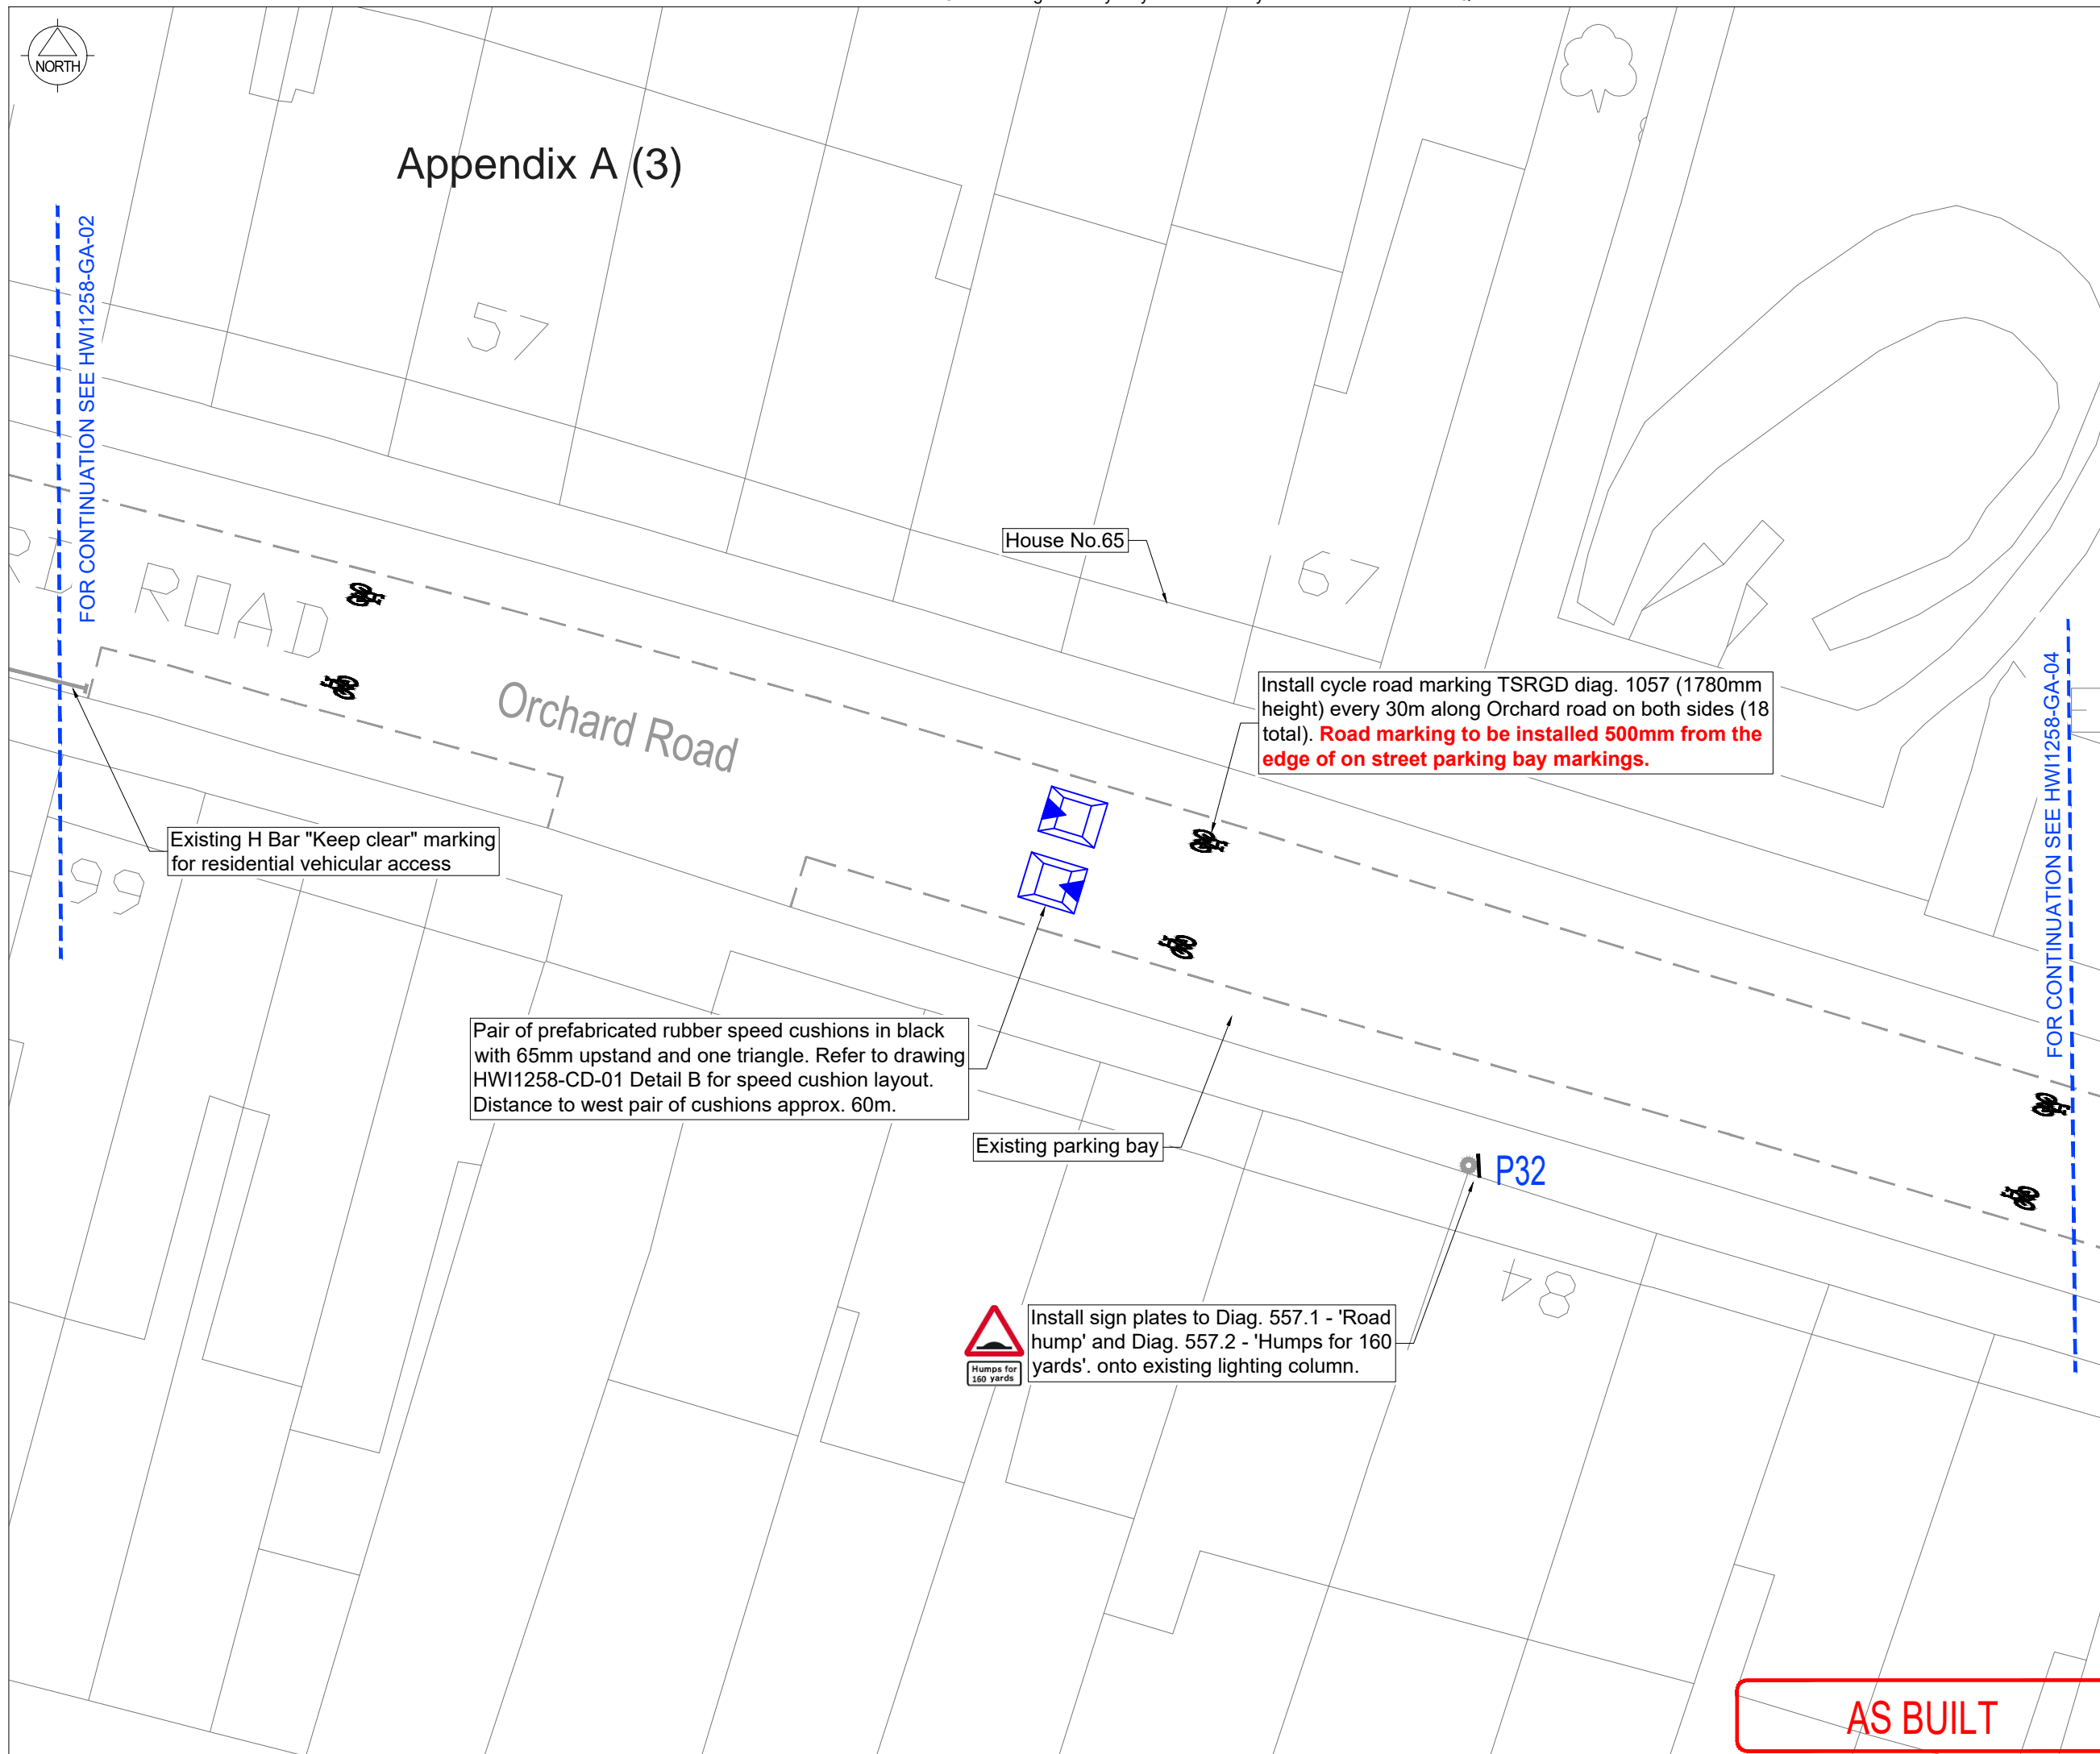

Install cycle road marking TSRGD diag. 1057 (1780mm height) every 30m along Orchard road on both sides (18 total). **Road marking to be installed 500mm from the edge of on street parking bay markings.**

Existing H Bar "Keep clear" marking for residential vehicular access

Pair of prefabricated rubber speed cushions in black with 65mm upstand and one triangle. Refer to drawing HW1258-CD-01 Detail B for speed cushion layout. Distance to west pair of cushions approx. 60m.

Install sign plates to Diag. 557.1 - 'Road hump' and Diag. 557.2 - 'Humps for 160 yards'. onto existing lighting column.

- General Notes:**
- All dimensions in meters, unless stated otherwise on drawing. Dimensions to be checked prior to commencement of any work by Engineer on Site. Notify the Engineer of any discrepancies before ordering materials or starting excavation.
 - Traffic management to be in accordance with chapter 8 of the traffic signs manual and related codes of practice.
 - Refer to statutory undertakers records for underground services located within the site extent.
 - Drawing to be printed in colour only. Do not scale from this drawing.
 - New construction levels & road markings to tie into existing.
 - All works are to be carried out in accordance with PCC standard details unless noted otherwise.
 - All traffic signs and road markings to be in accordance with the Traffic Signs Regulations and General Directions, 2016.
 - Ordnance Survey Copy Right - Based or reproduced from the 2008 Ordnance Survey 1/1000 base with the permission of HMSO crown copyright reserved. License No. LA-100019671.
 - All electric connection to DNO to be confirmed prior to the start of the works.
 - The set of drawings is composed by the following:
 - HW1258-LP-01 - Location Plan;
 - HW1258-TS-01 - Traffic Sign Schedule
 - HW1258-CD-01 - Construction Details
 - HW1258-GA-01 to 17 - General Arrangement - Sheets 01 to 17

- Legend:**
- Proposed rubber speed cushion 1650mm x 2000mm x 65mm. 750mm spacing between cushion pairs.
 - Proposed sign post and plate with reference number corresponding with schedule shown on drawing HW1258-TS-01
 - Existing sign and post to be removed
 - Proposed Road Marking
 - Existing Road Marking to be removed

Rev	Date	Revision Details	Amended	Approved
F	13.09.24	As Built drawing.	EA	FL
E	08.02.24	Signs and mounting type amended.	EA	FL
D	30.01.24	Issued for construction	CM	EA
C	23.08.23	Amended following RSA2 and issued for tender	CM	EA
B	27.07.23	ISSUE FOR RSA 2	CM	EA
A	06.07.23	First issue.	CM	EA

Project
Active Pompey Neighbourhoods (APN)

Drawing Title
General Arrangement (Preliminary Design) Sheet 3 of 17



Directorate of Economy, Planning and Transport
 Assistant Director (Infrastructure)
 Martin Lavers BSc CEng MICE

Date: July 2023 Scale: 1:200 @ A2
 Design/Survey by: CM Drawn by: CM Checked by: EA

Drawing No: **HW1258-GA-03** Revision No: **F**

FEASIBILITY	DRAFT	CONSTRUCTION
INFORMATION	TENDER	AS BUILT *

AS BUILT